


2077 East Warner Road : Tempe

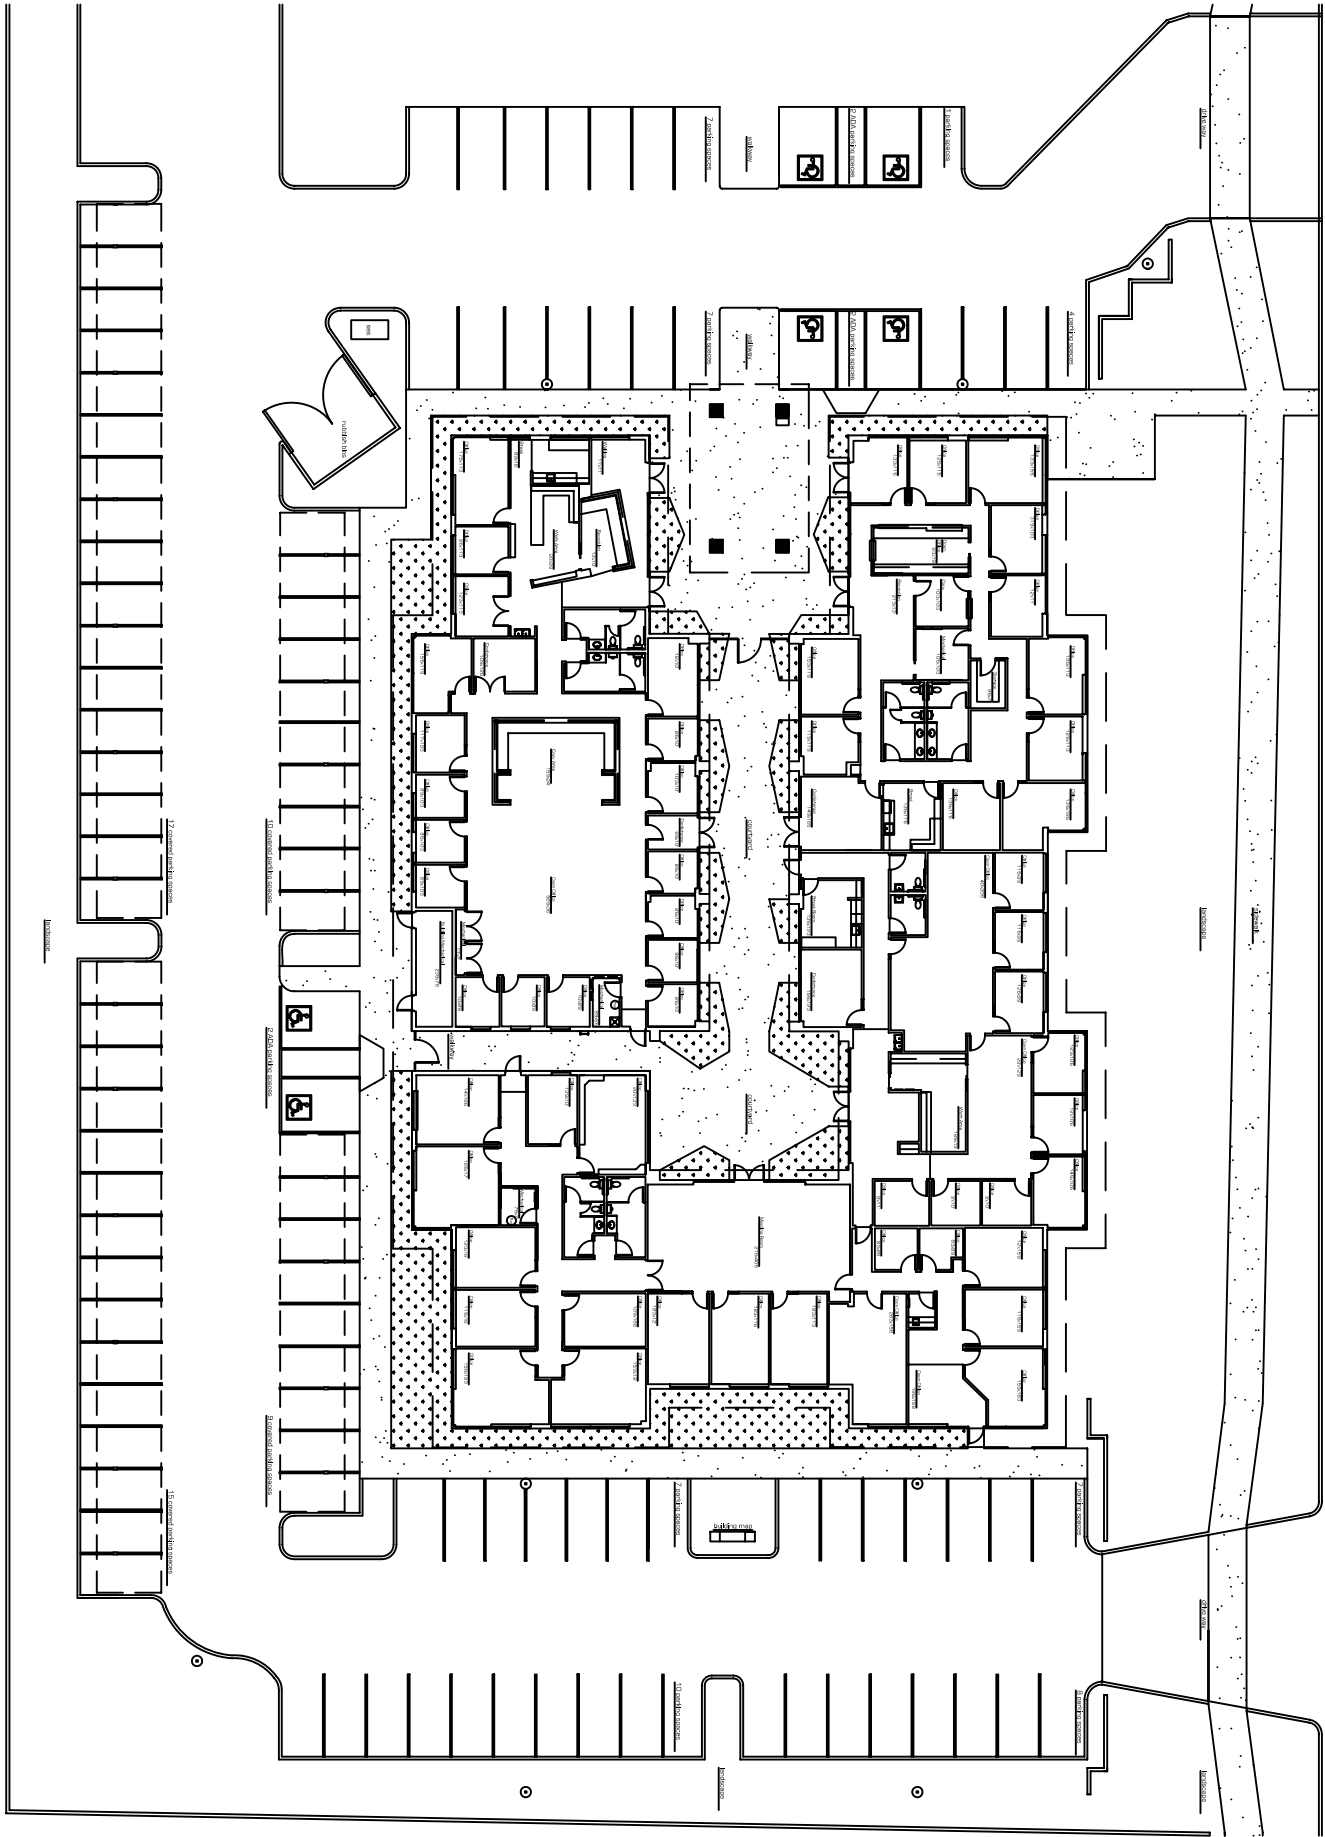

as-built

scale: nts
February, 2008

* All dimensions are approximate
* All information is of general nature

precision **MEASUREMENTS**

as built . space plans
architectural design

602.790.6412